

A SURVEY OF THE SW $\frac{1}{4}$ OF SECTION 34, T.19 S., R.2 W. OF THE 6TH P.M., CONTAINING 159.861 ACRES IN MCPHERSON COUNTY, KANSAS, AND OF A 109.403 ACRE PORTION THEREOF, BEING ALL OF SAID SW $\frac{1}{4}$ EXCEPT THE 50.458 ACRE IN THE SE COR. OF SAID SW $\frac{1}{4}$ AS SHOWN HEREON AND IS MORE PARTICULARLY DESCRIBED ON THE ATTACHED SHEET, ALL SUBJECT TO ROADWAY AND OTHER EASEMENTS AND AGREEMENTS OF RECORD.

SYNOPSIS OF EFFORTS TO RECOVER UNREFERENCED CORNERS (SHOWN HEREON AS "SET THIS SURVEY") AND NEW REFERENCE TIES TO EACH AS AS ESTABLISHED. SEE NOTES AT EACH LOCATION, AND SEE ALSO ATTACHED REPORT OF SURVEY.

S $\frac{1}{4}$ COR. SECTION 33
DUG 10 N-S X 25 E-W X 2.5 DEEP IN AREA FC. OR CROP LINES TO N & S - FOUND NOTHING.
TIES TO CORNER SET 6" DEEP:
26.35 N. TO SPK. TOP FC. POST
28.85 NNW TO SPK. IN P. POLE
27.85 NNE & 24.45 SSE TO TOP PIPE LINE MARKERS

SW COR. SECTION 34
DUG 10 N-S X 20 E-W X 4.5 DEEP ACROSS ROADWAY E-S IN ALL DIRECTIONS - FOUND NOTHING.
TIES TO CORNER SET 6" DEEP:
42.25 W. & 42.45 NE TO SPKS. IN P. POLES
39.35 NW TO SPK. TOP COR. FC. POST
63.2 ESE TO SPK. ANCH. POLE

W $\frac{1}{4}$ COR. SECTION 34
DUG 12 E-W X 15 N-S X 2.5 DEEP IN AREA HEDGE & FC. LINES TO E & W - FOUND NOTHING.
TIES TO CORNER SET 6" DEEP:
25.00 E. TO IRON BAR ON 4.5
36.85 SW & 35.1 NW TO SPKS. TOP FC. POSTS
25.7 W. TO SPK. TOP COR. FC. POST

N $\frac{1}{4}$ COR. SECTION 34
DUG 10 N-S X 25 E-W X 2.5 DEEP IN AREA HEDGE & FC. LINES TO N & S - FOUND NOTHING.
TIES TO CORNER SET 6" DEEP:
33.65 SSE TO SPK. COR. FC. POST
29.85 NNE - - - HEDGE POST
28.55 NNW - - - HEDGE POST
37.15 SW TO TOP 2ND STL. FC. POST W. OF FC. COR.

CENT. COR. SECTION 34
DUG PROBED & SCRAPPED IN 10 X 10 X 1.5-2' DEEP AREA AROUND FC. AND HEDGE INTERSECTIONS - FOUND NOTHING.
TIES TO CORNER SET AT SURFACE:
13.4 NNE & 7.25 NNW TO SPKS. IN W. SIDE 14" D. HEDGE TREES
14.3 E. TO SPK. N. SIDE 20" D. ELM

S $\frac{1}{4}$ COR. SECTION 34
DUG 10 N-S X 25 E-W X 2.5 DEEP BEFORE FINDING STONE AS DESCRIBED IN ORIGINAL SURVEY NOTES.
TIES TO IRON BAR SET TOP OVER CENTER AND 6" DEEP:
31.9 N TO SPK. TOP FC. POST
27.8 NNE TO SPK. P. POLE
79.55 NNW TO SPK. 15" D. TREE

"BELIEVE TO HAVE"
FOUND REFERENCED IP
FOR SW COR. SEC. 33,
T.19 S., R.2 W.

FOUND UNREFERENCED IP OF UNKNOWN ORIGIN AS MENTIONED ON PREVIOUS SURVEYS FOR NW CORNER SEC. 34, T.19 S., R.2 W.

SET 5" X 24" IRON BAR FOR W $\frac{1}{4}$ CORNER SEC. 34, T.19 S., R.2 W. ON A STRAIGHT LINE SPLIT BET. SW & NW CORNERS

TIES TO OTHER CORNERS:

SW COR. SECTION 33
REFERENCES MISSING
TIES TO "EXISTING" I.P.:
75.9 ESE, 50.0 ENE & 80.1 WSW TO SPKS. IN P. POLES
41.0 NW TO SPK. TOP FC. POST

NW COR. SECTION 34
PREVIOUSLY UNREFERENCED TIES TO "EXISTING" I.P.:
42.05 NW TO SPK. NEW P-POLE
68.3 NNW & 59.3 NNW TO EYES OF GUY ANCHORS
68.5 ESE TO TELE CABLE PEDESTAL

NE COR. SECTION 34
REFERENCES MISSING BUT CORNER USED PREVIOUSLY
TIES TO "EXISTING" I.P.:
48.85 NE & 79.65 WSW TO PIPE LINE MARKERS
46.25 NW TO SPK. P-POLE
39.85 ESE TO SPK. STR. P-POLE

E $\frac{1}{4}$ COR. SECTION 34
ADDITIONAL REFERENCES
TIES TO "EXISTING" I.P.:
50.0 E. TO SPK. HEDGE TREE
32.0 W. TO FC. POST
26.1 WSW TO SPK. P-POLE
31.0 NE & 41.7 SE TO N & S ENDS CMP CULVERT

NW $\frac{1}{4}$ SEC. 34,
T.19 S., R.2 W.

SET 5" X 24" IRON BAR FOR N $\frac{1}{4}$ CORNER SEC. 34, T.19 S., R.2 W. ON A STRAIGHT LINE SPLIT BET. NW & NE CORNERS

SET 5" X 24" IRON BAR FOR CENTER CORNER SEC. 34, T.19 S., R.2 W. AT INTERSECTION OF STRAIGHT LINES BETWEEN OPPOSITE 4 CORNERS

FOUND REFERENCED IRON BAR FOR NE CORNER SEC. 34, T.19 S., R.2 W.

FOUND REFERENCED IRON BAR (R.R. SPIKE) FOR E $\frac{1}{4}$ CORNER SEC. 34, T.19 S., R.2 W.


SW $\frac{1}{4}$ SECTION 34,
T.19 S., R.2 W.
TOTAL ACRES = 159.861

109.403 ACRES

EXCEPTED AREA - SEE DESCRIPTION ATTACHED
50.458 ACRES



SCALE: 1"=300'

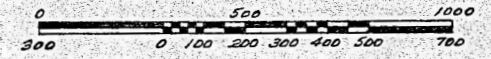

LEGEND OF SYMBOLS

- ▲ DENOTES GOV'T CORNER FOUND
- ▲ DENOTES 5" X 24" IRON BAR SET FOR GOV'T CORNER THIS SURVEY - SEE NOTES AND TIES AT LEFT, AND THE ATTACHED REPORT OF SURVEY
- DENOTES 5" X 24" IRON BAR SET FOR BOUNDARY R/W OR OTHER CORNER THIS SURVEY
- DENOTES FLAGGED NAIL SET FOR CORNER THIS SURVEY
- DENOTES FLAGGED STAKE SET ON BOUNDARY THIS SURVEY
- RS. DENOTES DATA FROM PREVIOUS SURVEYS BY OTHERS
- EDM DENOTES DISTANCE MEASURED ELECTRONICALLY
- CALC. DENOTES CALCULATED VALUES

I HEREBY CERTIFY THIS PLAT OF SURVEY TO BE A TRUE AND CORRECT REPRESENTATION OF THE PROPERTY DESCRIBED ABOVE AND ON THE ATTACHED SHEET AS SURVEYED BY ME FROM DATA FURNISHED BY THE MCPHERSON COUNTY ENGINEERS OFFICE OR COMPILED FROM FIELD FINDINGS, IN KEEPING WITH ACCEPTED AND STANDARD SURVEYING PRACTICE, AND TO THE BEST OF MY KNOWLEDGE AND ABILITY, THIS 29TH DAY OF JANUARY 1981.

William Klassen

PREPARED FOR: DAROLD AND ELDON WEDEL RFD #2 Box #28 CANTON, KANSAS 67428	
BY: SICKMON-KLASSEN, LAND SURVEYORS 611 EAST 4 TH AVE. P.O. BOX #1691 HUTCHINSON, KANSAS 67501 (316) 663-7401	
SURVEYED BY: KLASSEN-PORTER	PROJECT NO.: SK-80-124
COMPUTED-DRAWN-CHECKED KLASSEN	DATE: 29 JANUARY 1981